

12 JUL 2012  
326-040  
COMMUNITIES



# APPLICATION FOR A MODIFICATION ORDER

WILDLIFE AND COUNTRYSIDE ACT 1981  
DEFINITIVE MAP MODIFICATION ORDERS

(This form to be completed by the applicant and returned to Lincolnshire County Council)

To: Definitive Map Officer, Public Rights of Way, Development Directorate,  
Lincolnshire County Council, City Hall, Lincoln, LN1 1DN

## APPLICATION

I/We GREETHAM WITH SOMERSBY PARISH MEETING  
of 1 HELLWOBRY WAY HORNCASTLE Lincs Postcode LN9 5EU

hereby apply for an order under Section 53 of the Wildlife and Countryside Act, 1981, to modify the  
Definitive Map and Statement for the area by:

*\*(Delete any of the following sections which do not apply)*

~~\*Deleting the footpath / bridleway / restricted byway/byway open to all traffic (delete as appropriate)~~

~~From.....To.....  
Parish of.....Parish of.....~~

OR

~~\*Adding the footpath / bridleway / restricted byway/byway open to all traffic (delete as appropriate)~~

~~From.....To.....  
Parish of.....Parish of.....~~

OR

\*Upgrading / ~~Downgrading~~ the footpath / bridleway / ~~restricted byway / byway open to all traffic~~ to a footpath / bridleway / ~~restricted byway / byway open to all traffic~~ (delete as appropriate)

From SOULS LANE GREETHAM To HIGH TOWN / TETFOED ROAD (OPPOSITE GREETHAM LODGE)  
Parish of GREETHAM WITH SOMERSBY Parish of GREETHAM WITH SOMERSBY

OR

~~\*Varying the particulars of the footpath / bridleway / restricted byway/byway open to all traffic (delete as appropriate)~~

~~From.....To.....  
Parish of.....Parish of.....~~

~~By amending to.....~~



(in all cases) and shown on the map annexed hereto.

I / We attach copies of the documentary and / or user evidence in support of this application, as listed below.

Signed. [REDACTED] ..... Date 2.07.12 .....


**SUPPORTING EVIDENCE**

**User Evidence**

I enclose .3... User Evidence Forms in support of this application.

**AND / OR (delete as appropriate)**



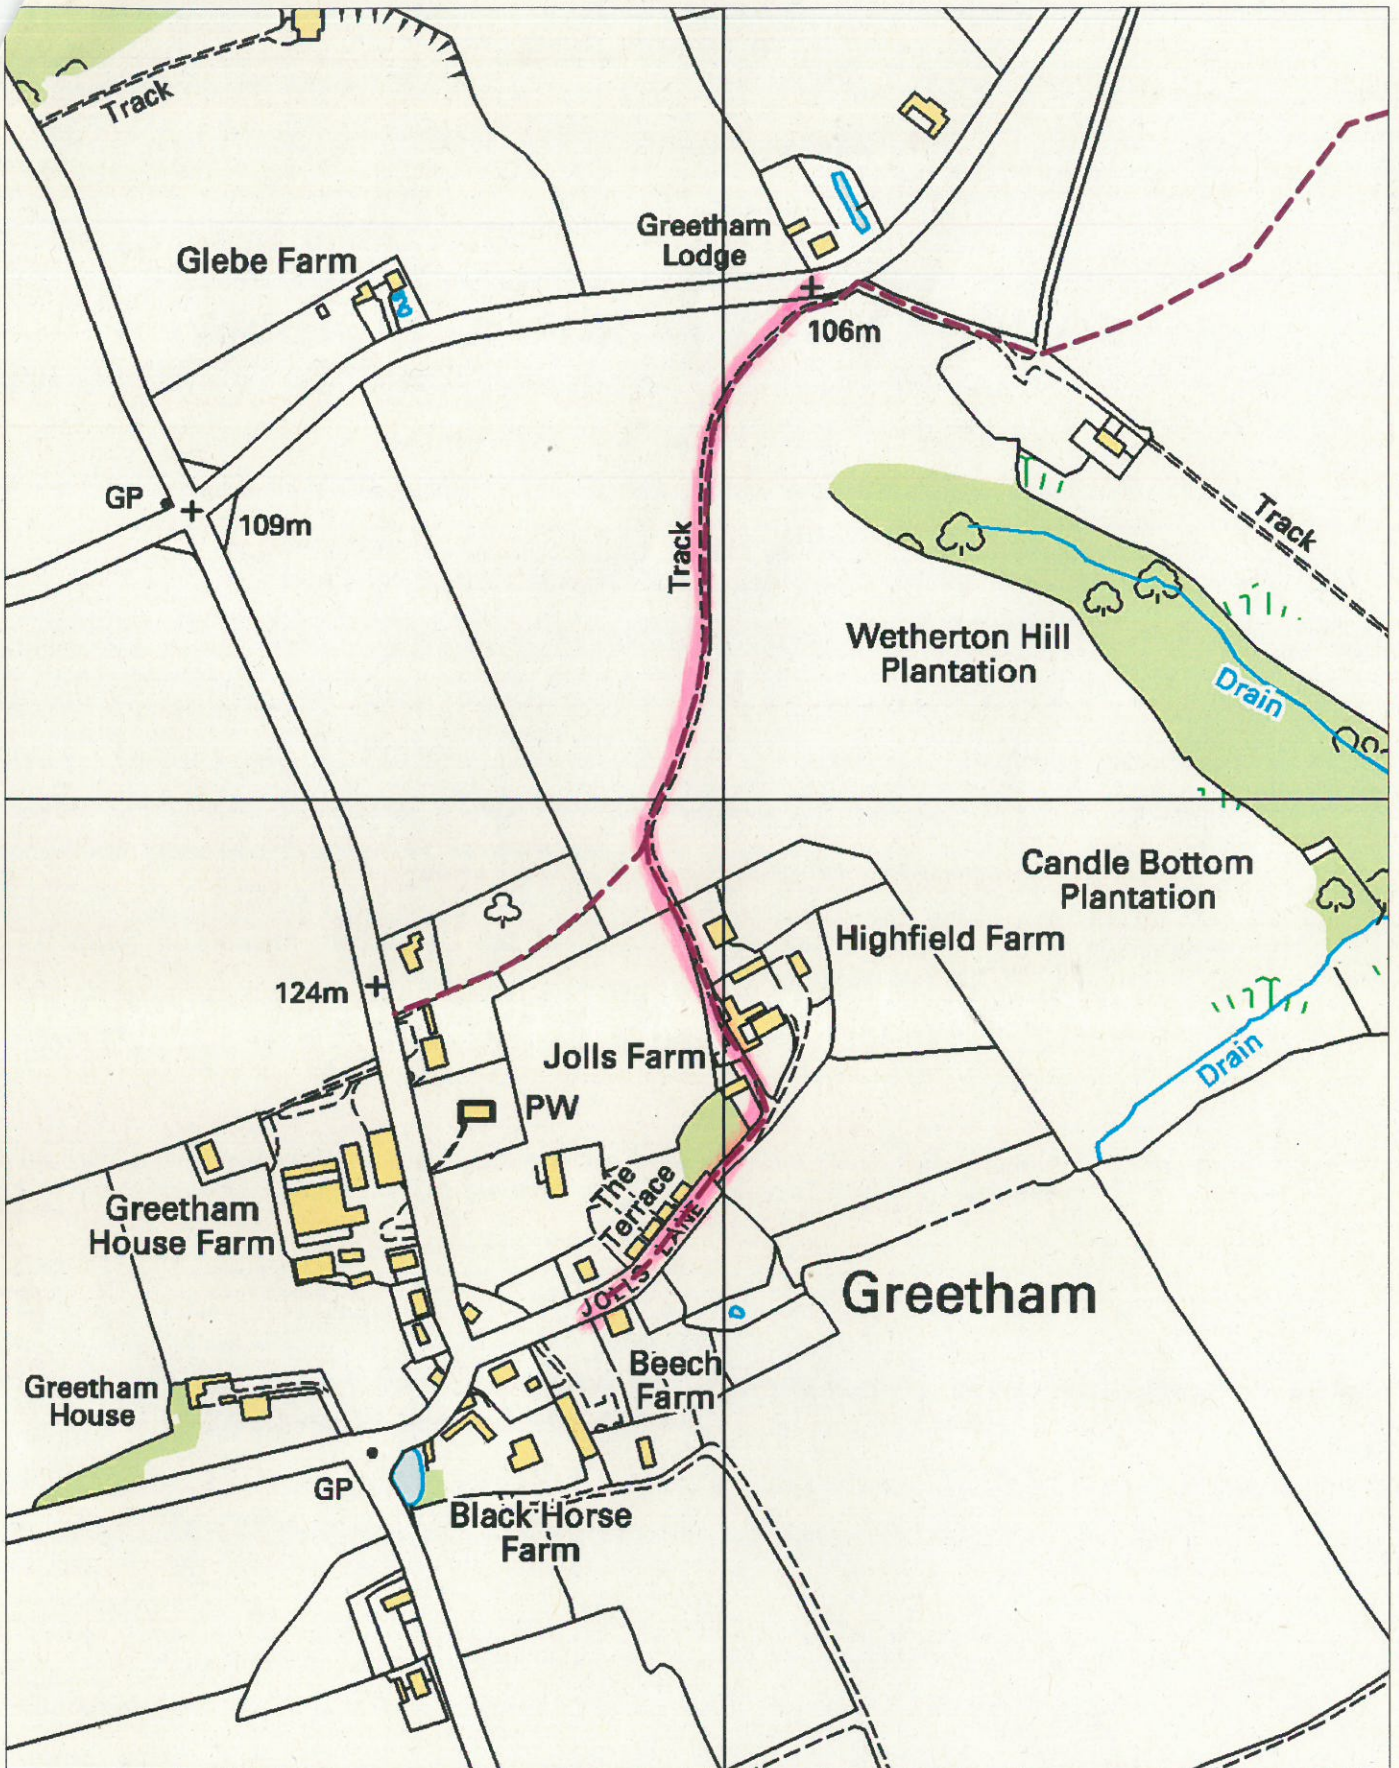

**Key:**

Public Footpath ---



**Plan Details :**

DMMO Application:  
Upgrade of Public Footpath

Scale: 1 : 4500

The map is reproduced from Ordnance Survey materials with the permission of Ordnance Survey on behalf of the Controller of Her Majesty's Stationery Office. Crown copyrights. Unauthorised reproduction infringes Crown Copyright and may lead to prosecution or civil proceedings. Lincolnshire County Council 100025370, 2011

Public Rights of Way & Countryside Access  
R A Wills, Director for Communities  
City Hall, Orchard Street, Lincoln. LN1 1DN