

WILDLIFE AND COUNTRYSIDE ACT 1981

KESTEVEN COUNTY COUNCIL (RURAL DISTRICT OF SOUTH KESTEVEN)

DEFINITIVE MAP AND STATEMENT

LINCOLNSHIRE COUNTY COUNCIL (AMENDMENT OF KESTEVEN COUNTY COUNCIL
(RURAL DISTRICT OF SOUTH KESTEVEN) DEFINITIVE MAP AND STATEMENT -
EVIDENTIAL EVENTS) (NO. 1) MODIFICATION ORDER 1992

WHEREAS pursuant to Section 53(2)(b) of the Wildlife and Countryside Act 1981 (hereinafter called "the Act") it appears to Lincolnshire County Council (hereinafter called "the surveying authority") that the Definitive Map and Statement for the area of the former Kesteven County Council (Rural District of South Kesteven) require modification in consequence of an event specified in Section 53(3)(c)(i) of the Act namely the discovery by the surveying authority of evidence which when considered with all other relevant evidence shows that there is a public footpath over land shown in the Map and Statement

AND WHEREAS the surveying authority have consulted with every local authority whose area includes the land to which the Order relates

NOW THEREFORE the surveying authority in exercise of the powers conferred on them by Section 53(2)(b) hereby make the following Order:-

1. For the purpose of this Order the relevant date shall be 26 February 1992
2. The Kesteven County Council Definitive Map and Statement for the area of the former Rural District of South Kesteven shall be modified as described in Part I and Part II of the Schedule and

shown on the annexed map

3. This Order shall have effect on the date it is confirmed

4. This Order may be cited as the Lincolnshire County Council (Amendment of Kesteven County Council (Rural District of South Kesteven) Definitive Map and Statement - Evidential Events (No. 1) Modification Order 1992

SCHEDULE

PART I

Modification of Definitive Map

Description of Path to be added

In the Borough of Stamford

A public footpath running from the southern end of the public highway, Cherryholt Road, OS Grid Reference TF 03628 07075, generally south-south-eastwards between two boundary fences for a distance of approximately 40 metres to meet the bank of the River Welland, then running generally north-eastwards along the river bank for a distance of approximately 463 metres to a point on the north side of the river, OS Grid Reference TF03999 07314, then turning generally north-north-westwards for a distance of approximately 124 metres along the east side of a boundary to meet the public highway known as Priory Road at Grid Reference TF 03935 07420.

The total length of the path being approximately ~~670~~⁶²⁷ metres and indicated by a broken line between the points A-B-C-D on the annexed Drawing No. A4/1432/33

The width of the path varies as follows:-

A to B - approximately 1 metre

B to C to D - approximately 2 metres


6418.NN1

G. N. K
DIRECTOR

Lincolnshire Co
County Office

Produced from/bas
approved with the sa
approval of H.M. Str

OWN COPYRIGHT
15 SEP
LICENCE NO.

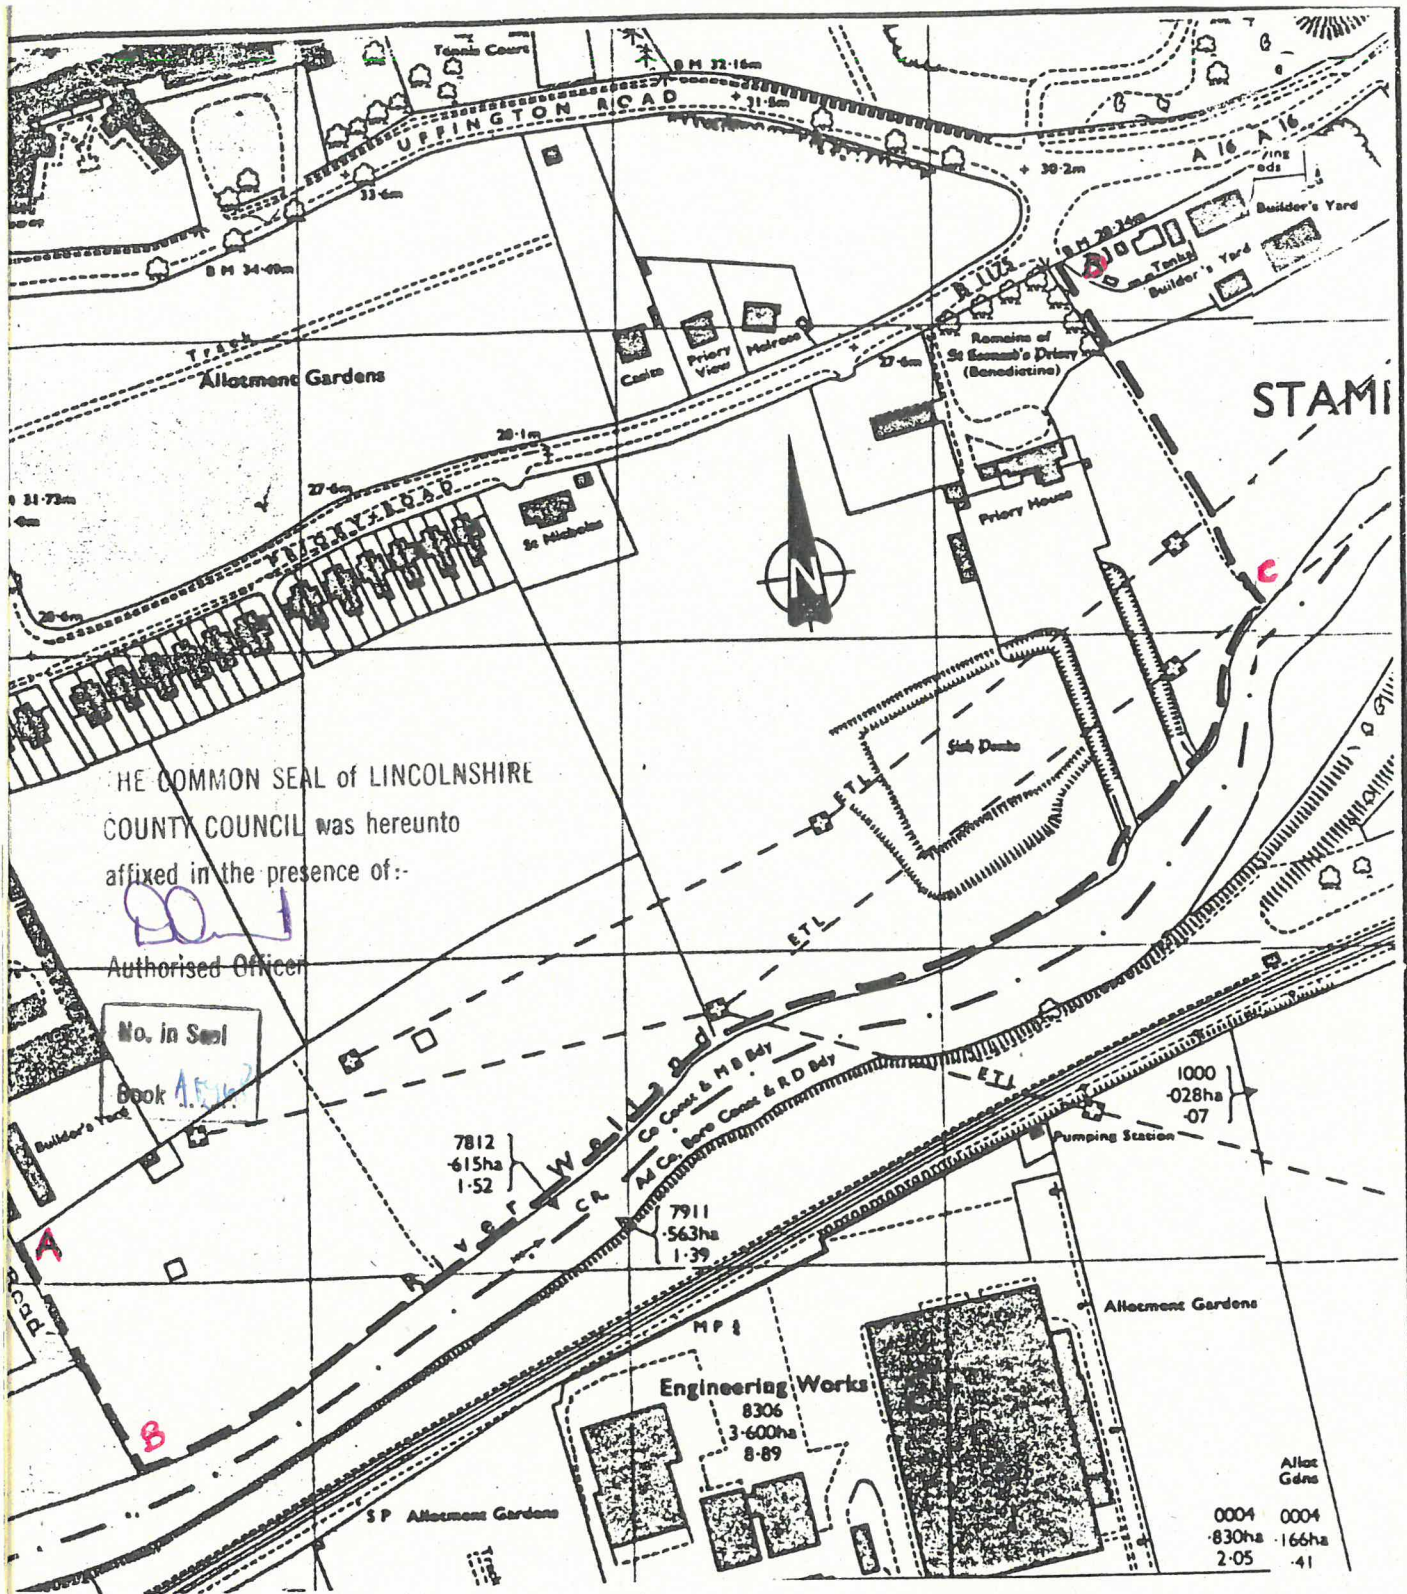

THE COMMON SEAL of LINCOLNSHIRE COUNTY COUNCIL was hereunto affixed in the presence of:-

[Signature]
 Authorised Officer

No. in Seal
 Book *1514*

LEGEND

--- Claimed Additional Footpath.

G. N. KEIGHLEY MSc., Dip.PE., CertEd. DIRECTOR OF RECREATIONAL SERVICES		<h1>Lincolnshire</h1>	
Dr/Date SAT 9/87		Scale 1:2500	
Checked		Approved	
O.S. sheet reference TFO207-0307 TFO407-0507		STAMFORD:- Lincolnshire County Council. (Definitive Map Modification Order). Claimed Additional Footpath from Cherryholt Road to Priory Road.	
O.S. sheet reference TFO207-0307 TFO407-0507		Drawing No. A4/1432/33	
File/Holding No. PL/C 18/19			

1
 il
 th
 o.
 ublic
 075,
 for
 the
 the
 point
 314,
 e of
 meet
 3935
 nd
 he

Lincolnshire County Council
 County Offices, Lincoln
 issued from/based upon the
 map with the sanction of the
 Controller of H.M. Stationery Office.
 ALL RIGHTS RESERVED
15 SEP 1987
 Licence No. LA07134X

PART II

Modification of Definitive Statement

Variation of Particulars of Paths

The following details shall be added

A public footpath running from the southern end of the public highway, Cherryholt Road, OS Grid Reference TF 03628 07075, generally south-south-eastwards between two boundary fences for a distance of approximately 40 metres to meet the bank of the River Welland, then running generally north-eastwards along the river bank for a distance of approximately 463 metres to a point on the north side of the river, OS Grid Reference TF03999 07314, then turning generally north-north-westwards for a distance of approximately 124 metres along the east side of a boundary to meet the public highway known as Priory Road at Grid Reference TF 03935 07420

The total length of the path being approximately 627 metres and indicated by a broken line between the points A-B-C-D on the annexed Drawing No. A4/1432/33

The width of the path varies as follows:-

A to B - approximately 1 metre

B to C to D - approximately 2 metres

GIVEN under the Common Seal of Lincolnshire County Council this

20th

day of February

One thousand nine

hundred and ninety-two


THE COMMON SEAL of)

LINCOLNSHIRE COUNTY COUNCIL)

was hereunto affixed in the)

presence of:-)

Authorised Officer

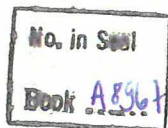

The foregoing order is hereby confirmed subject to the red ink modifications thereon

Dominic Young 16 MAY 2019

An Inspector appointed by The Secretary of State for Environment, Food and Rural Affairs

DATED

26 February

1992

WILDLIFE AND COUNTRYSIDE ACT 1981
KESTEVEN COUNTY COUNCIL (RURAL
DISTRICT OF SOUTH KESTEVEN)
DEFINITIVE MAP AND STATEMENT

LINCOLNSHIRE COUNTY COUNCIL
(AMENDMENT OF KESTEVEN COUNTY
COUNCIL (RURAL DISTRICT OF SOUTH
KESTEVEN) DEFINITIVE MAP
STATEMENT - EVIDENTIAL EVENTS)
(NO. 1) MODIFICATION ORDER 1992

P J BURNS
Chief Solicitor
County Offices
Lincoln

