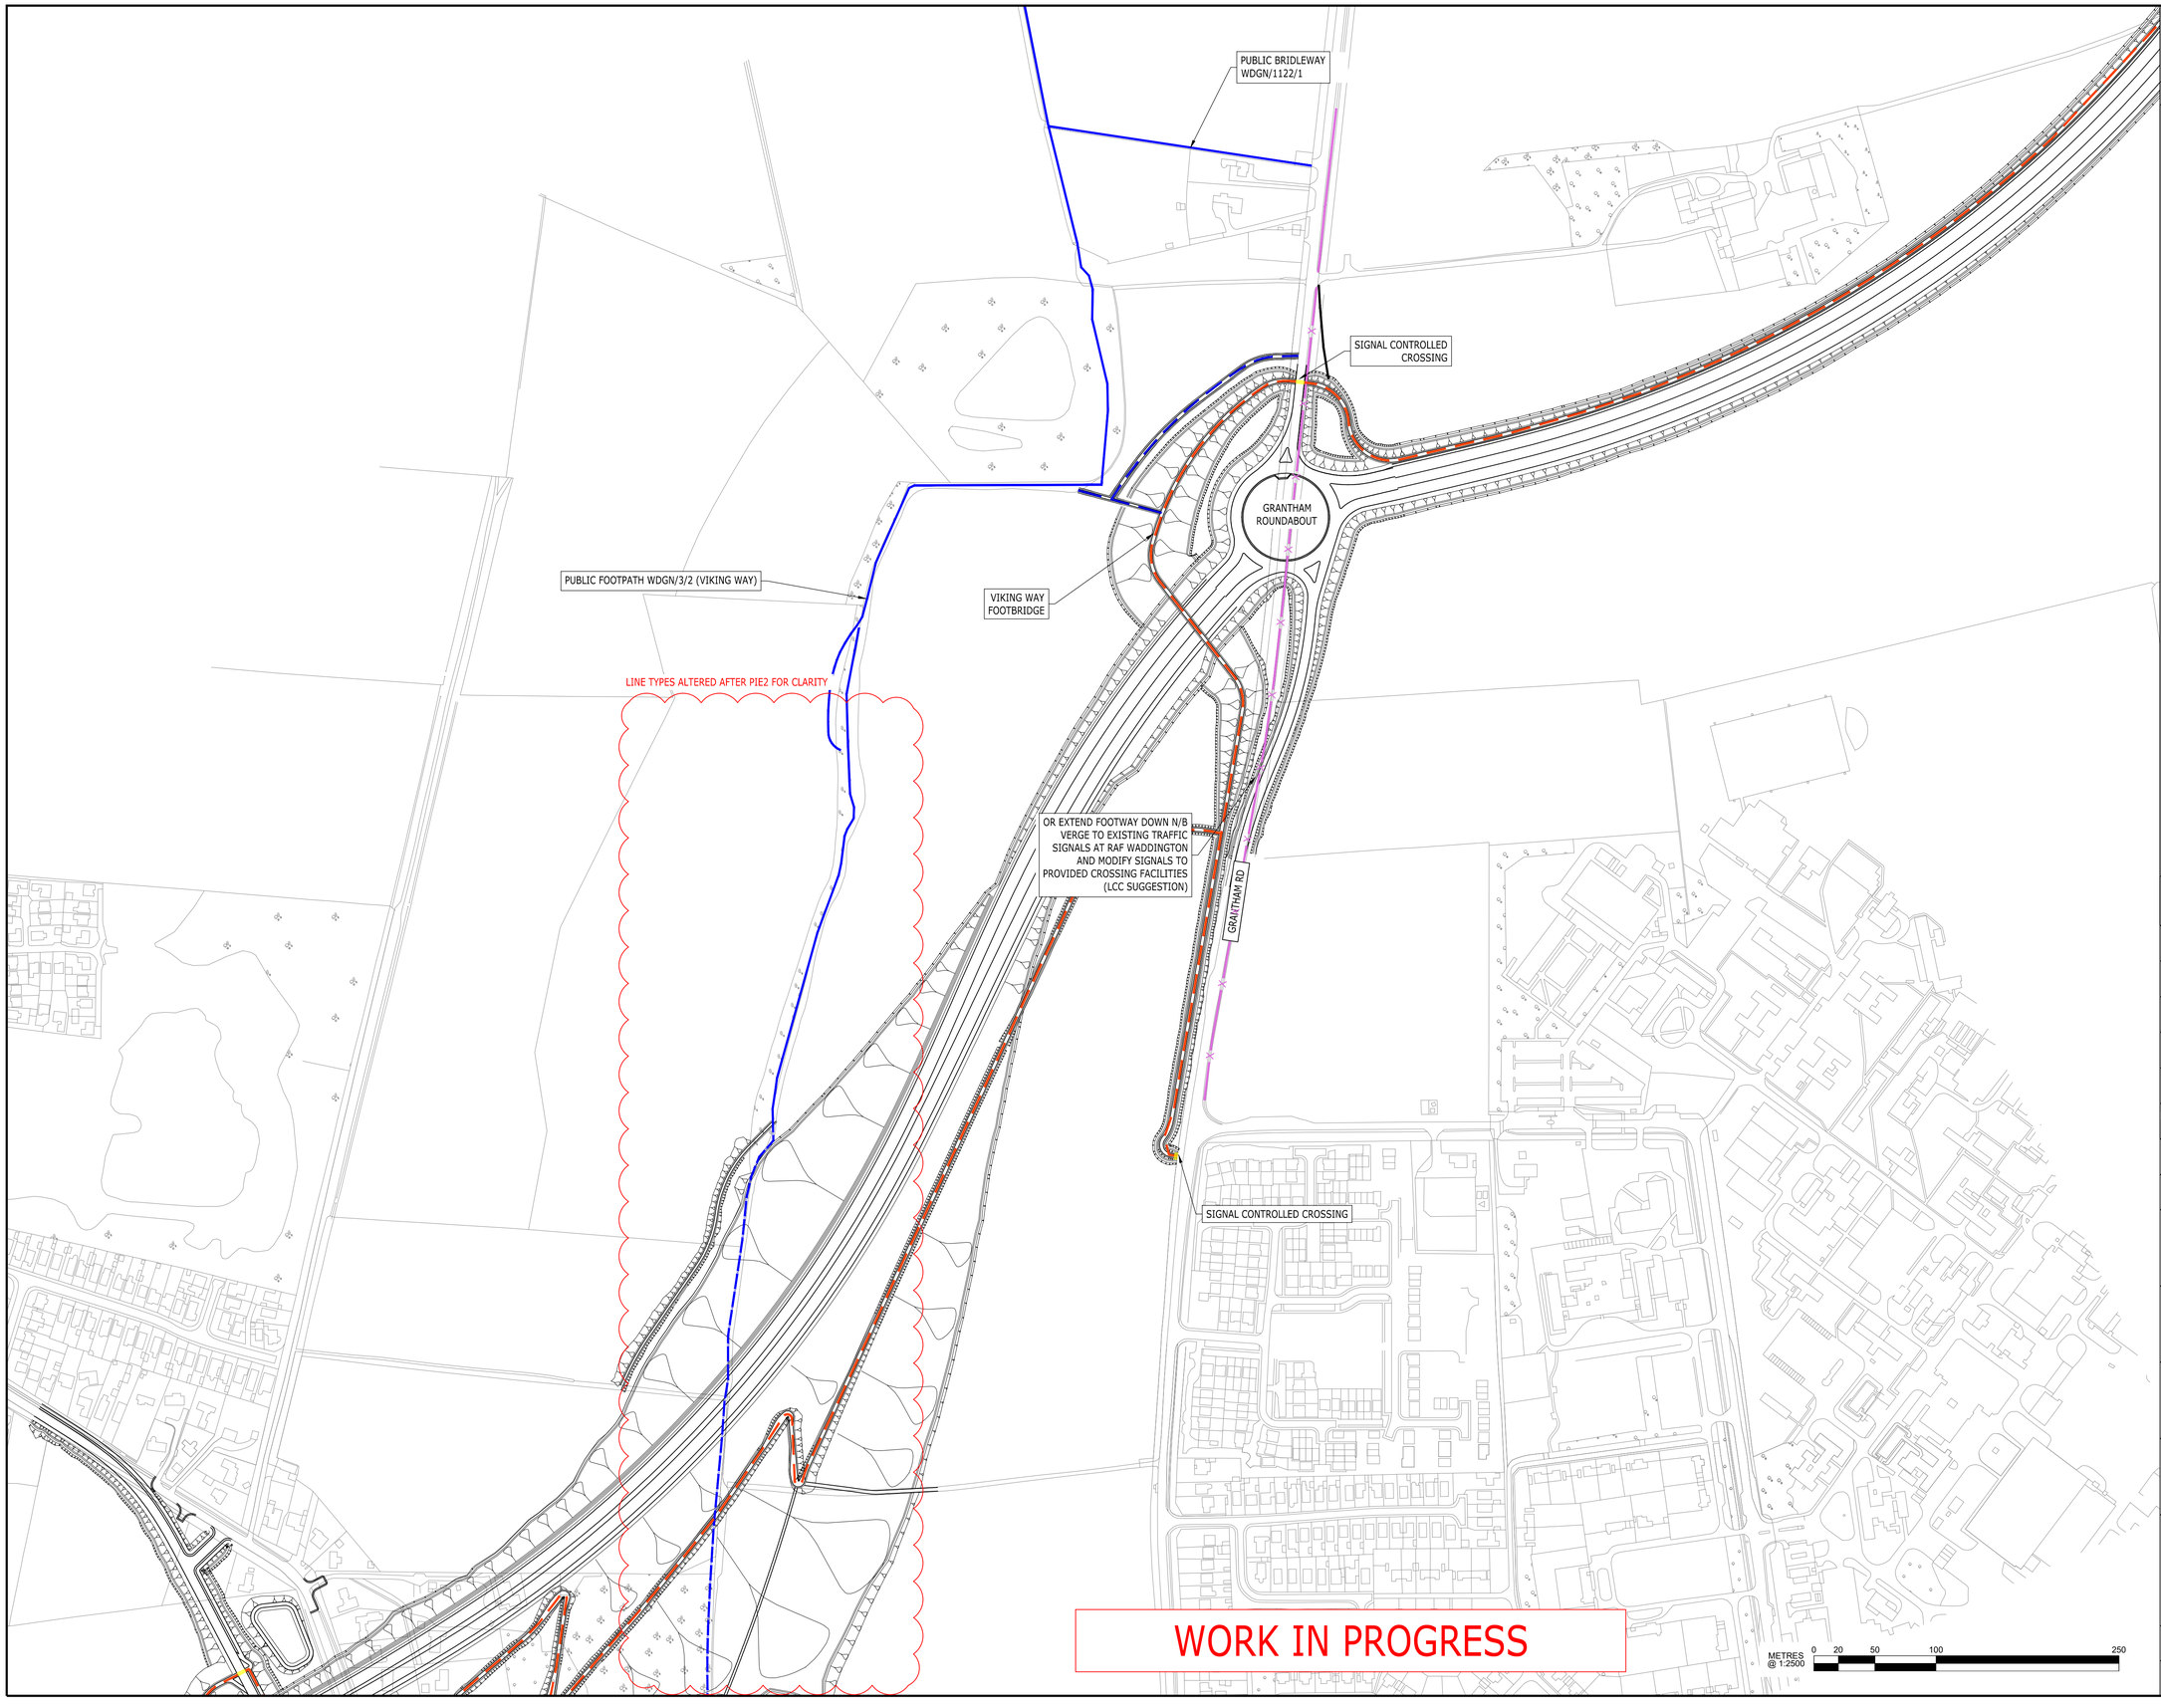

COPYRIGHT RAMBOLL UK LIMITED. ALL RIGHTS RESERVED. THIS DOCUMENT IS ISSUED FOR THE PARTY WHO COMMISSIONED IT AND FOR THE SPECIFIC PURPOSES CONNECTED WITH THE PROJECT ONLY. IT SHOULD NOT BE RELIED UPON BY ANY OTHER PARTY OR USED FOR ANY OTHER PURPOSE. RAMBOLL ACCEPTS NO RESPONSIBILITY OR LIABILITY WHICH MAY ARISE FROM RELIANCE OR USE OF THIS DOCUMENT OR THE DATA CONTAINED HEREIN BY ANY OTHER PARTY OR FOR ANY OTHER PURPOSE.

Notes

1. DO NOT SCALE FROM THIS DRAWING.
2. ALL DIMENSIONS ARE IN METRES UNLESS SHOWN OTHERWISE.
3. ALL LEVELS ARE IN METRES ABOVE ORDNANCE DATUM UNLESS SHOWN OTHERWISE.
4. THIS DRAWING IS TO BE READ IN CONJUNCTION WITH ALL RELEVANT ARCHITECTS AND ENGINEERS DRAWINGS AND SPECIFICATIONS.
5. PROPOSED SHARED USE FACILITY, REFER TO LCC SD/11/4 - USE FOOTWAY TO REAR OF KERB DETAIL
6. PROPOSED FOOTWAY, REFER TO LCC SD/11/4 - USE FOOTWAY TO REAR OF VERGE DETAIL. USE SAME DETAIL FOR WHERE SHARED USE FACILITY DEVIATES AWAY FROM NHRR.

KEY

- PROPOSED RED LINE BOUNDARY
- EXISTING SHARED USE FACILITY TO BE RETAINED
- EXISTING SHARED USE FACILITY TO BE EXTINGUISHED
- PROPOSED SHARED USE FACILITY (PEDESTRIAN & CYCLE) 3m WIDE
- EXISTING PROW PUBLIC FOOTPATH TO BE RETAINED
- EXISTING PROW PUBLIC FOOTPATH TO BE EXTINGUISHED
- PROPOSED PROW PUBLIC FOOTPATH
- EXISTING PROW PUBLIC BRIDLEWAY TO BE RETAINED
- EXISTING PROW PUBLIC BRIDLEWAY TO BE EXTINGUISHED
- PROPOSED PROW PUBLIC BRIDLEWAY
- PROPOSED SIGNAL CONTROLLED CROSSING
- PROPOSED FOOTWAY, 2m WIDE
- STEPPED CONNECTION
- UNCONTROLLED CROSSING
- EXISTING FOOTWAY TO BE EXTINGUISHED
- EXISTING FOOTWAY TO BE RETAINED

Reproduced by permission of Ordnance Survey on behalf of HSMO. © Crown copyright and database right 2022. All rights reserved. Ordnance Survey License number 100025370

Rev	Description	Drawn	Checked	Approved	Date
P02.1		HI	---	---	---

Suitability: S0 — Drawing Status: Work in Progress

Project Name: North Hykeham Relief Road

Project Client: Lincolnshire County Council — Working for a better future

Project Contractor: Balfour Beatty

Project Designer: RAMBOLL

tel 01244 311855 chester@ramboll.co.uk
www.ramboll.co.uk

Drawing Title: PUBLIC INFORMATION EXHIBITION 2 NMU PROPOSALS SHEET 5 OF 6

Project No:	Scale (@A1):	Drawn:	Date:
1620013942	1:2500	HI	---

Drawing No: NHRR-RAM-ENM-HYKE-SK-ZH-00005 — Rev: P02.1